

① SITE - AS-BUILT
1" = 20'-0"

Autodesk® Revit®

www.autodesk.com/revit

Consultant
Address
Address
Phone
Fax
e-mail

Consultant
Address
Address
Phone
Fax
e-mail

No.	Description	Date

GREEN TEAM

SITE - AS-BUILT

Project number	Project Number
Date	Issue Date
Drawn by	Author
Checked by	Checker

C101

Scale 1" = 20'-0"

Autodesk® Revit®

www.autodesk.com/revit

Consultant
Address
Address
Phone
Fax
e-mail

Consultant
Address
Address
Phone
Fax
e-mail

No.	Description	Date

GREEN TEAM


SITE - DEMO

Project number	Project Number
Date	Issue Date
Drawn by	Author
Checked by	Checker

C102

Scale 1" = 20'-0"

① SITE - DEMOLISHED
1" = 20'-0"

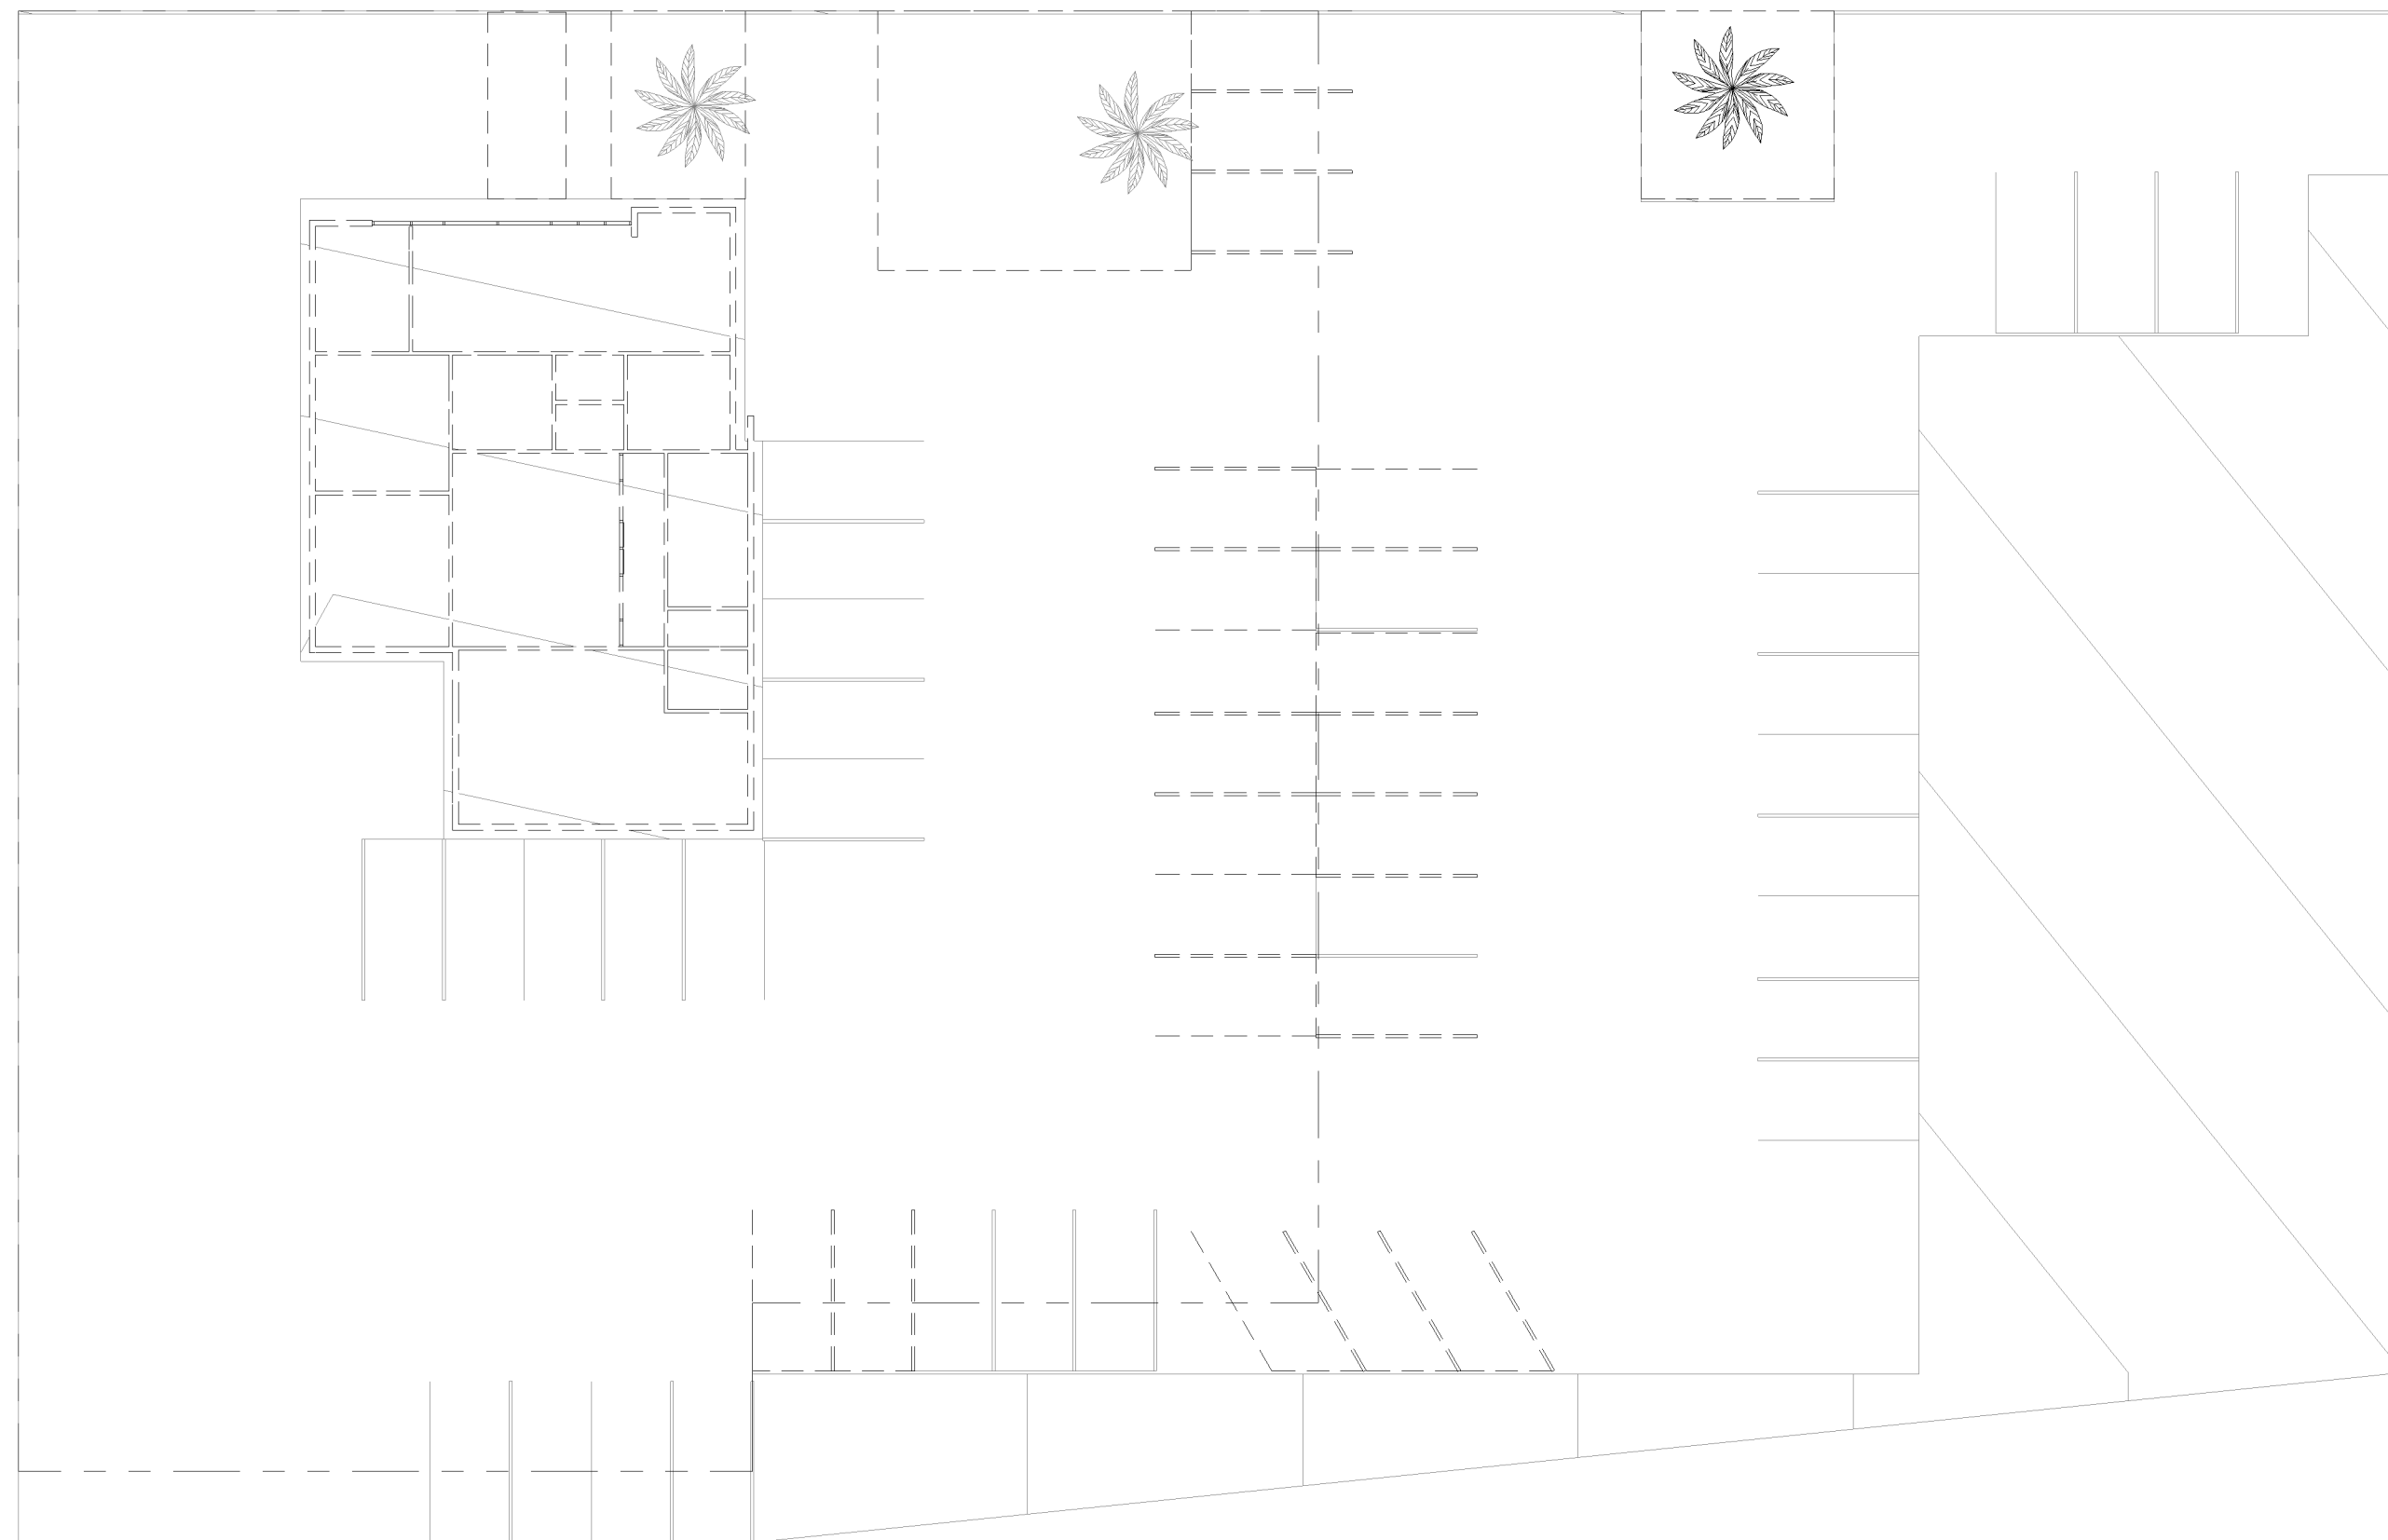

Autodesk® Revit®

www.autodesk.com/revit

Consultant
Address
Address
Phone
Fax
e-mail

Consultant
Address
Address
Phone
Fax
e-mail

No.	Description	Date

GREEN TEAM


SITE - CHAMBER
OF COMMERCE

Project number	Project Number
Date	Issue Date
Drawn by	Author
Checked by	Checker

C103

Scale 1" = 20'-0"

3/6/2014 3:57:49 PM

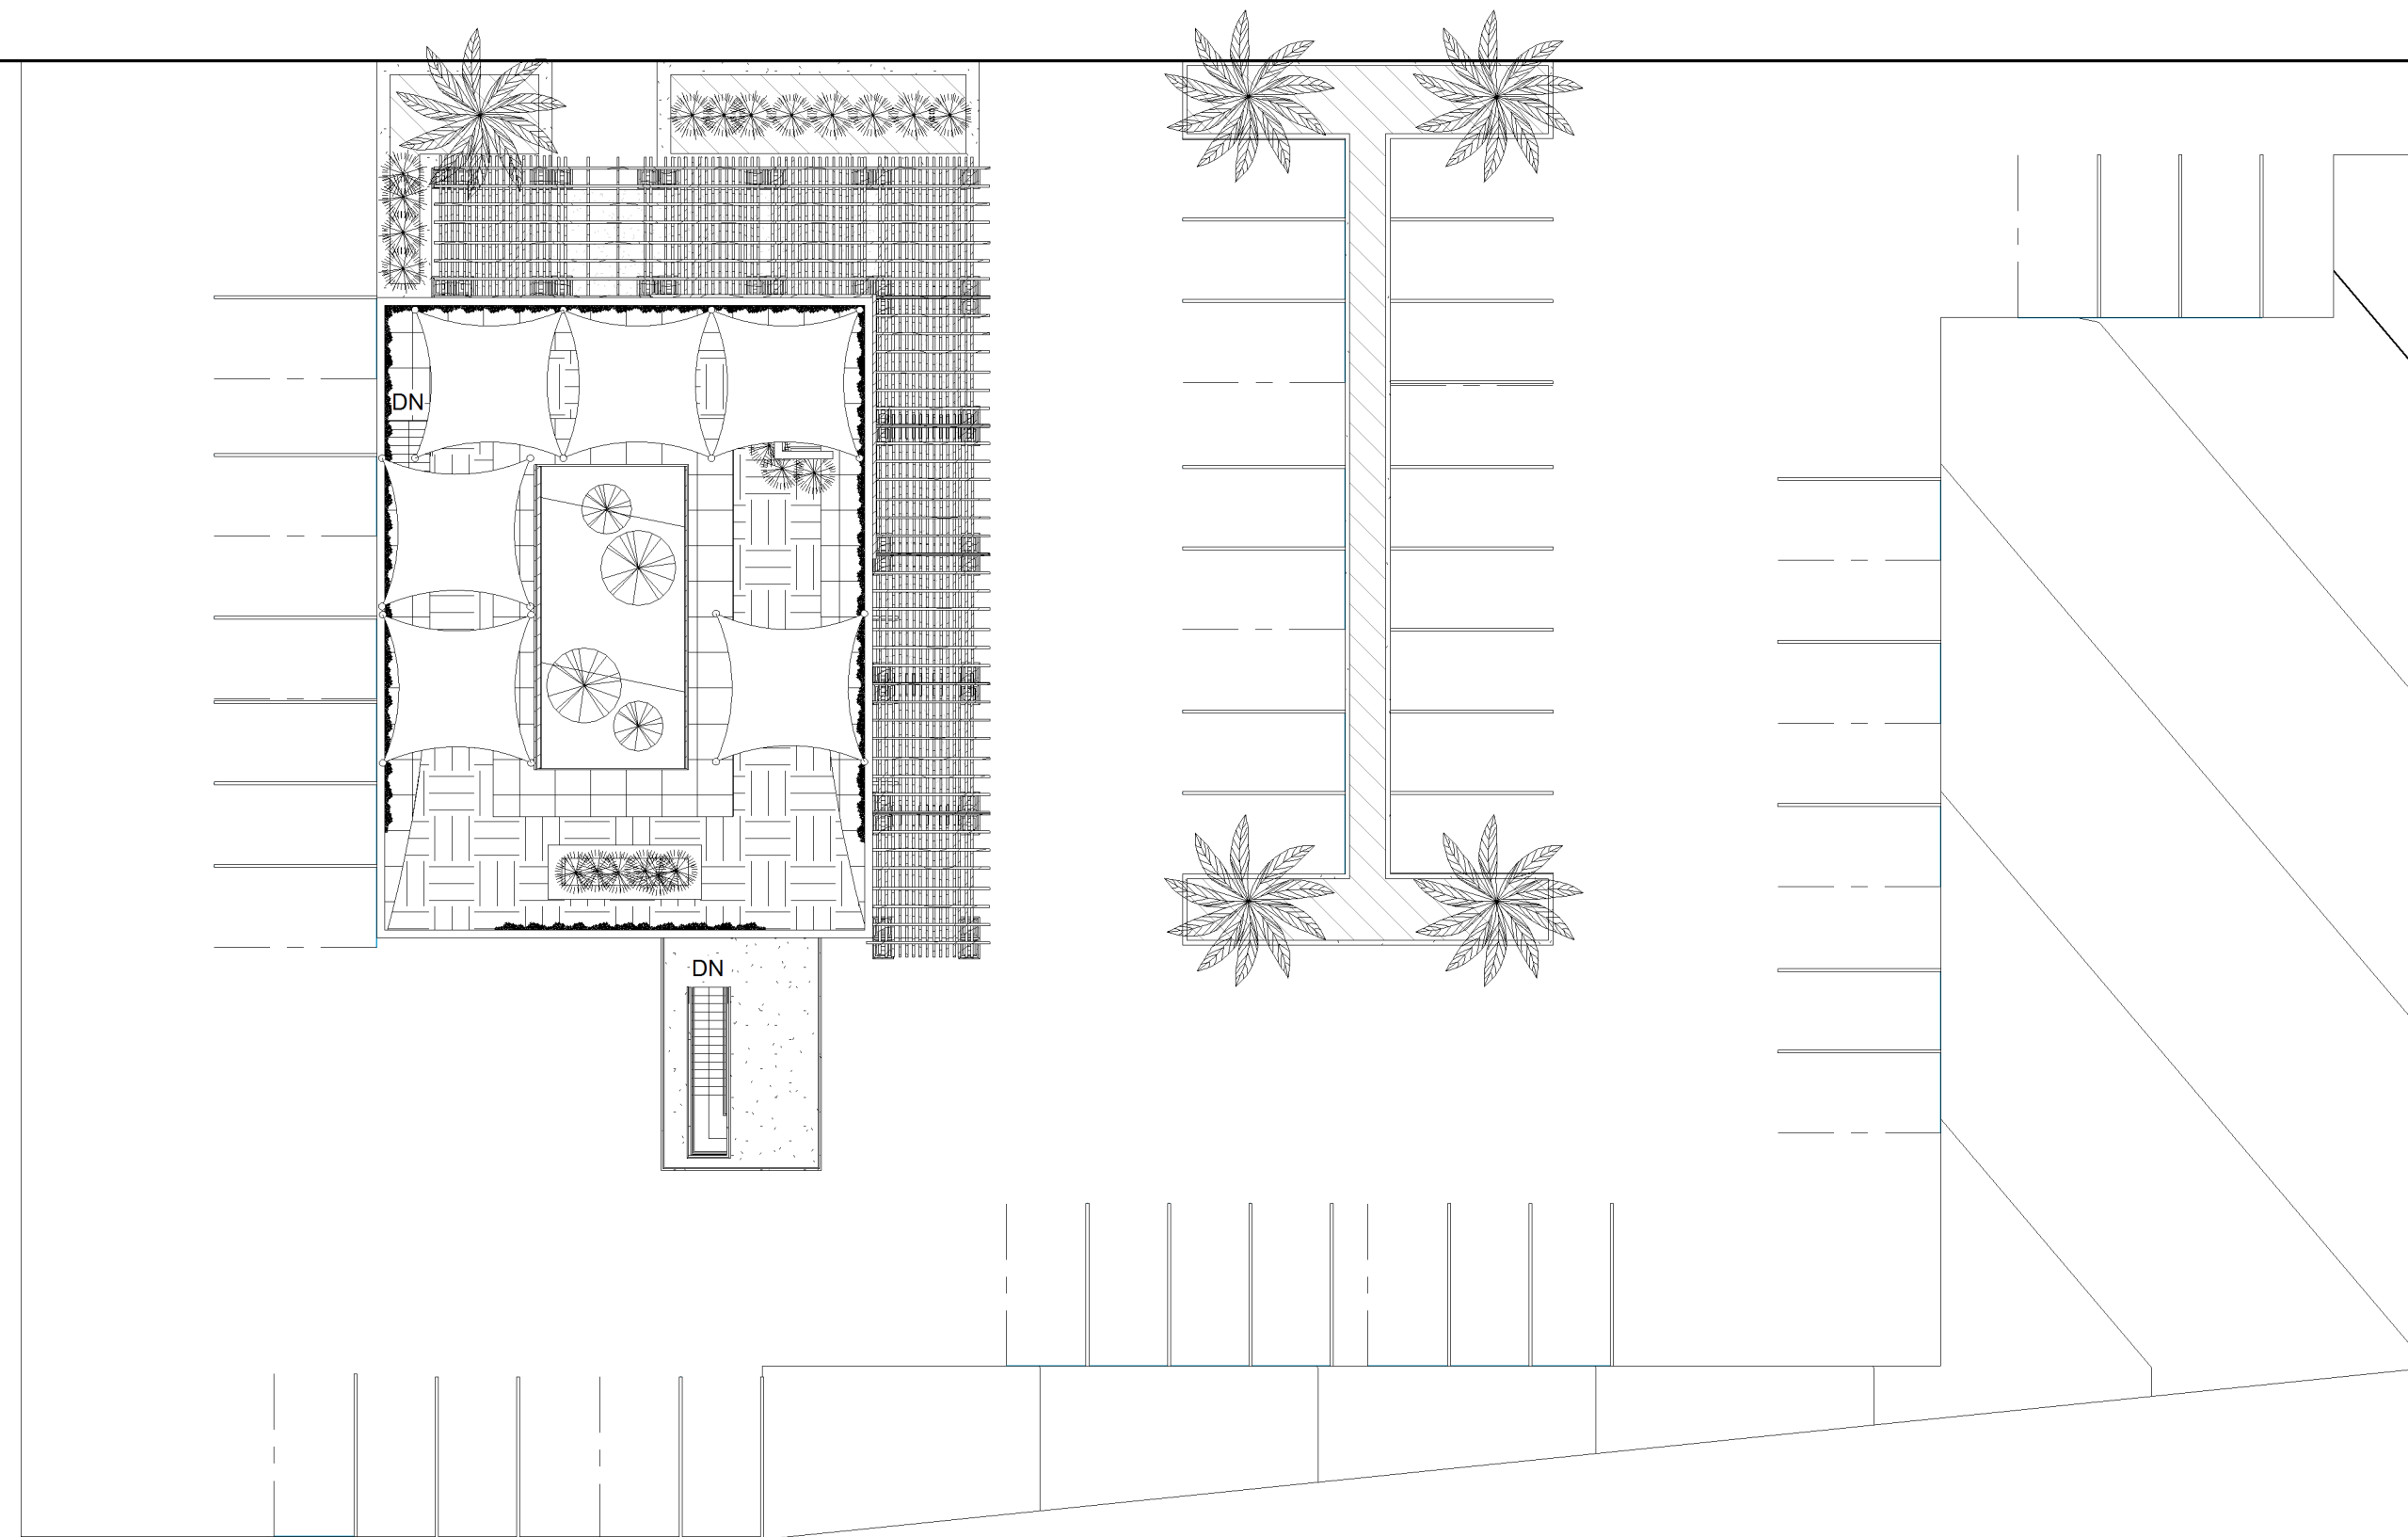

① SITE - CHAMBER OF COMMERCE
1" = 20'-0"